


SLUTTDOKUMENTASJON

Ikke målsatte hull ø22

3	3	Sylinderstift syrefast A4 ø10*30			
1	2	FOTPLATE TEGN. NR 4-4062		52	
1	1	IPE 400 KVAL.S355J2G3	7767	515	NS-EN10025
Ant.	Pos.	Vare nr.	Navn, dim., kval.	Kpl.	Vekt Anm

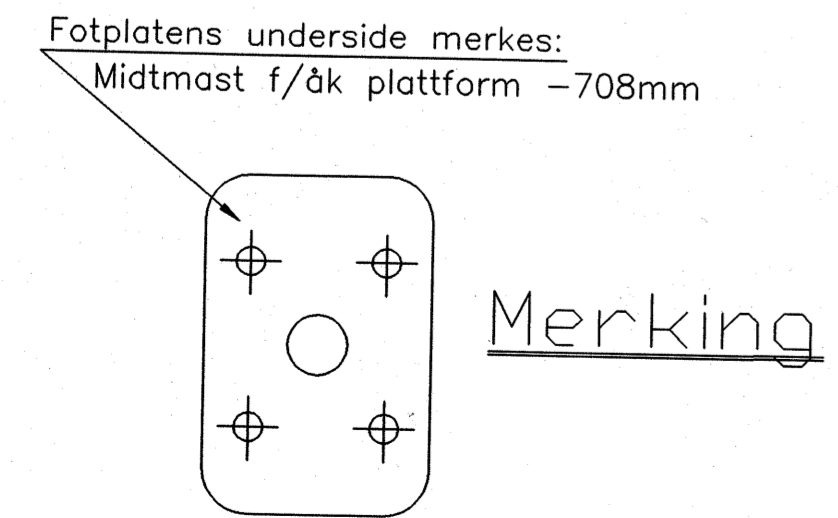

Merknader.

- NS 3472 Kontrollklasse 2
- NS 3420 Toleranseklasse 2
- NS 3420 Sveiseklasse B

Overflatebehandling.

- Varmforsinking i.h.t. NS 1978 klasse A
- Sur avfetting.Sinkfosfatering.
- Pulverbelegging tykkelse 60-100my
- Farge: Grønn NCS 9005G20Y matt struktur.
- Polyester.

F01	22.05.98	F01	JSM	JSM	JSM
Rev.	Dato	Endring - erstatning	Tegn.	Saksb.	Sign.
NSB Gardermobanen A/S			Date	22.05.98	
ABB Energi AS - kontrakt K-1839			Saksb.	JSM	
Kontrakt nr. NG 85645	Leverandør: Ørsta Stålindustri AS		DA		
Avstand Oslo S	Leverandør tegn. nr. 2-3620		DAK nr.	0059.DWG	
Parsell			Hor. M.	1:20	
Vert. M.			Ark. bet.		
Område			Erstatn. for		
Tekst - beskrivelse	MIDTMAST M. LØS TOPP FOR ÅK PÅ PLATTFORM -708 mm GARDERMOBANEN		Omritekode		
GHB tegn. nr. E000-M-TD-74-0059			Rev.	F01	
NSB tegn. nr.					