


SLUTTDOKUMENTASJON

Ikke målsatte hull ø22

Ant.	Pos.	Vare nr.	Navn, dim., kval.	Kpl.	Vekt	Anm
2	3		Sylinderstift syrefast A4 ø10*30			
1	2		VARV.PL.40*300 KVAL.S355J2G3	600	57	NS-EN10025
1	1		IPE 400 KVAL.S355J2G3	8625	572	NS-EN10025

Fotplaten underside merkes
Fotplate for B2 fundament

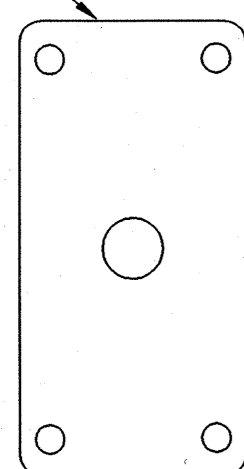

Merking

Merknader.

- NS 3472 Kontrollklasse 2
- NS 3420 Toleranseklasse 2
- NS 3420 Sveiseklasse B

Overflatebehandling.

Varmforsinking i.h.t. NS 1978 klasse A
Sur avfetting, Sinkfosfatering.
Pulverbelegging tykkelse 60-100my
Farge: Grønn NCS 9005G20Y matt struktur.
Polyester.

Oppmerka felt maskeres før lakkering

Rev.	Dato	Endring - erstatning	JSM	JSM	JSM
<p>NSB Gardermobanen A/S</p>			<p>Dato 22.05.98 Saksb. JSM</p>		
<p>ABB Energi AS - kontrakt K-1839</p>					
Kontrakt:	NG 85645	Leverandør:	<p>Ørsta Stålinndustri AS DAK nr. 0068.DWG</p>		
Avstand Oslo S	Leverandør Tegn. nr. 2-3629	Hor. M. Vert. M.	<p>1:20</p>		
<p>Parcell</p>			<p>Ark. bet.</p>		
<p>Område</p>			<p>Erstatn. for</p>		
<p>Tekst - beskrivelse</p> <p>NORMALMAST FOR UTLIGGER FOTPLATE FOR B2 FUNDAMENT GARDERMOBANEN</p>					
<p>GHB Tegn. nr. E000-M-TD-74-0068</p>			<p>Rev. F01</p>		
<p>NSB Tegn. nr.</p>					

Referansescale (mm) 100 50 0

ABB Energi AS - kontrakt K-1839