


SLUTTDOKUMENTASJON

Ikke målsatte hull ø22

Ant.	Pos.	Vare nr.	Navn, dim., kval.	Kpl.	Vekt	Anm
3	3		Sylinderstift syrefast A4 ø10*30			
1	2		FOTPLATE TEGN. NR 4-4062		52	
1	1		IPE 400 KVAL.S355J2G3	7675	509	NS-EN10025

Fotplattens underside merkes
 Akmast -800

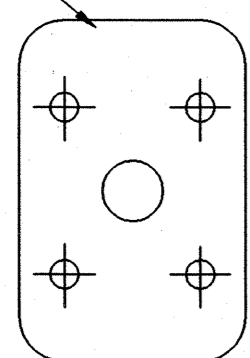

Merking

Merknader.

- NS 3472 Kontrollklasse 2
- NS 3420 Toleranseklasse 2
- NS 3420 Sveiseklasse B

Overflatebehandling.

- Varmforsinking i.h.t. NS 1978 klasse A
- Sur avfetting Sinkfosfatering
- Pulverbelegging tykkelse 60-100my
- Farge: Grønn NCS 9005G20Y matt struktur.
- Polyester.

Oppmerka felt maskeres før lakkering

Rev.	Dato	Endring - erstatning	Tegn.	Saksb.	Sign.
F01	22.05.98	Som bygget	JSM	JSM	JSM
NSB Gardermobanen A/S			Dato 22.05.98 Saksb. JSM		
ABB Energi AS - kontrakt K-1839			DA		
Kontrakt nr. NG 85645		Leverandør: Ørsta Stålindustri AS		DAK nr. 0084.DWG	
Avstand Oslo S		Leverandør tegn. nr. 2-3649A		Hor. M. 1:20 Vert. M.	
Parsell			Ark. bet.		
Område			Erstatn. for		
Tekst - beskrivelse ÅKMAST FOR UTLIGGER PÅ PLATTFORM -800 mm GARDERMOBANEN			Områdekode		
GNB tegn. nr. E000-M-TD-74-0084			Rev. F01		
NSB tegn. nr.			Rev.		