


1) Tegn. Nr.
2) Firmategn
Materiale: AlMgSi1-F31 DIN 1749

SLUTTDOKUMENTASJON

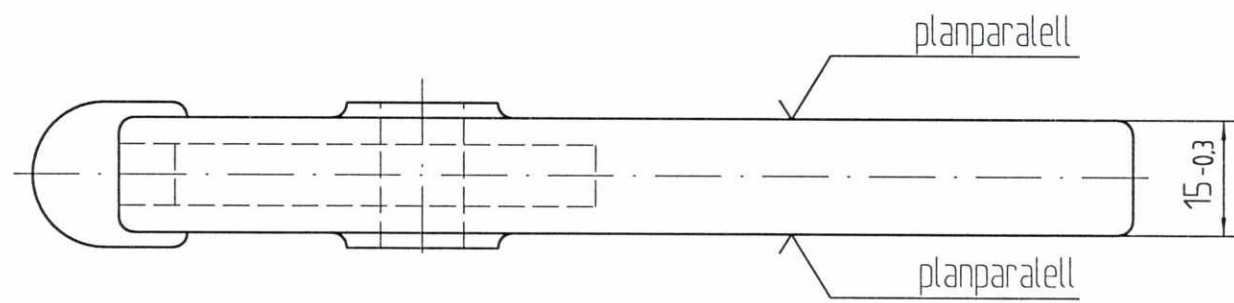

Radier uten angivelse har R = 2mm

| | | | | | |
|---------------|----------|----------------------|------------------------------|----------|-------|
| F02 | 16.02.98 | Som bygget | Gr. | Kr. | AM |
| B01 | 11.01.96 | For akseptering | AME | Kr. | Cat. |
| Rev. | Dato | Endring - erstatning | Tegn. | Saksb. | Sign. |
| | | | Dato | 21.09.95 | |
| | | | Saksb. | AME | |
| | | | DA | Kr. | |
| | | | OA | Cat. | |
| | | | DAK nr. | | |
| | | | Hor. M. | 1 : 1 | |
| | | | Vert. M. | | |
| | | | Ark. bet. | | |
| | | | Erstatn. for | | |
| | | | Områdekode | | |
| | | | Krok for lett direksjonsstag | | |
| GMB Tegn. nr. | | | E000-M-TD-74-0916 | | |
| NSB Tegn. nr. | | | Rev. | | |
| | | | F02 | | |
| | | | Rev. | | |

Fuer dieses Dokument und den darin dargestellten Gegenstand behalten wir uns alle Rechte vor. Vervielfaeltigung, Bekanntgabe an Dritte oder Verwertung seines Inhalts sind ohne unsere ausdrueckliche Zustimmung verboten.

Allgemeintoleranzen fuer Form und Lage

