


**SLUTTIDOKUMENTASJON**

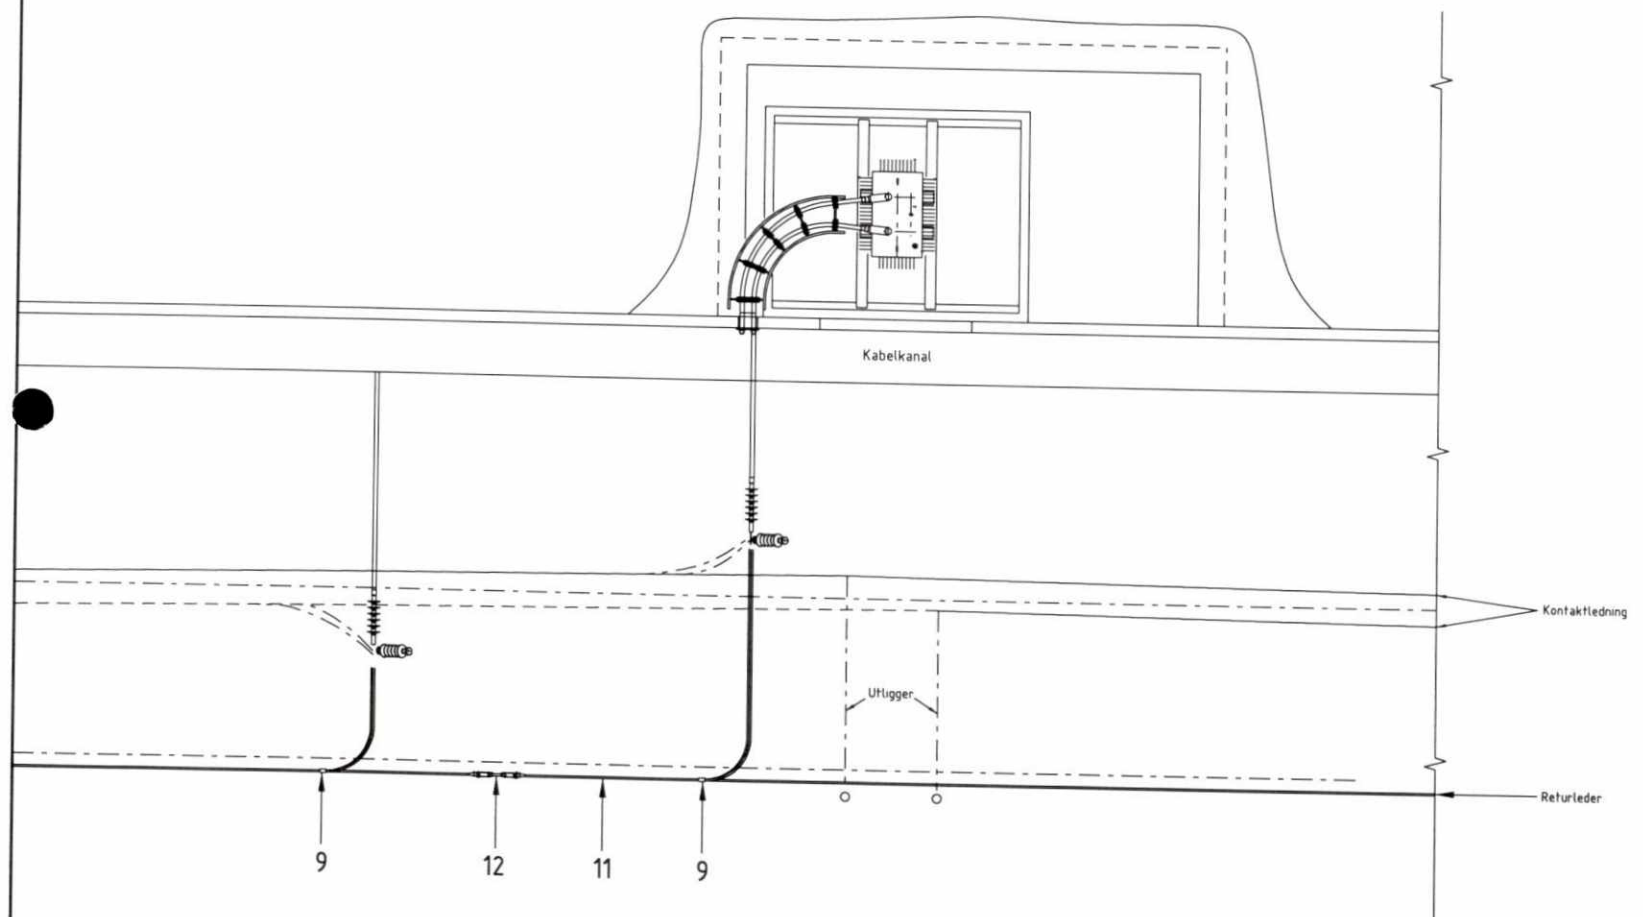

Pos. nr	Mengde	Enhet	Beskrivelse	Type	Spenningsnivå	Material nr	Referanse
15	2	stk	Bjelke				E000-M-TH-74-0134
14	nødv		Kabelbro	Wibe KHZP			
13	nødv	stk	Kabelklammer				E000-M-TD-74-0109
12	4	stk	Isolator	Reliable (ENSTO NTP)			ENSTO NTP nr K33743 50
11	nødv	m	Al-line nr 150	Halogenfri isolasjon	1 kV		
10	nødv	m	Kabel	TXSI 36 kV 1 x 400/35 mm <sup>2</sup>			
9	4	stk	Al - bøyleketøy	Karl Pfisterer			El nr 28 715 52
8	1	stk	Støtteisolator	Rebosio			
7	1	stk	Brakett for støtteisolator				E000-M-TD-74-0115
6	4	stk	Kabelsko	Elpress AKK 400-16			El nr 20 430 62
5	2	stk	Kabelendemuffe	Elastimold 775LR/CS268	1250 A 4,5 kV		
4	2	stk	Kabelendemuffe	Raychem EPKT-36E1X0	1 400V 205W346		
3	3	stk	Tildeckingshette	Maxefa 331 993			El nr 28 742 32
2	2	stk	Transformatorlemme	Maxefa 331 993 993			El nr 28 742 28
1	1	stk	Sugetransformator	ABB Kraft 93 kVA	780/780 A 119/119 V		T2-403060

Rev	Dato	Endring - årsak	TEGN	SAKSH	Sign
F01	08 02 00	Som bygget			FOR FOR ALA
<b>NSB Gardermobanen A/S</b> ABB Energi AS - kontrakt K-1839			Dato: 08 02 00 Saksh: FOR		
Kontrakt nr: <b>ABB</b> ABB Kraft AS Leverandør tegn nr: <b>9BET010042-NAM</b>			DAK nr: Hor. M. Vart. M.: <b>1.50</b>		
Arrangement <b>SUGETRANSFORMATOR I UTSTØPT TUNNEL</b>			Derskilt nr: <b>000</b>		
Derskilt nr: <b>E000-M-TH-74-0052</b>			Rev: <b>F01</b>		