

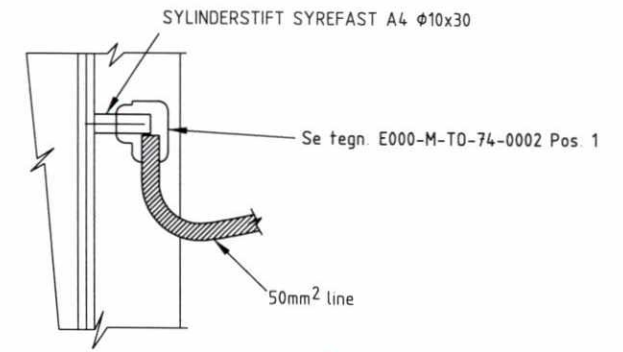


SNITT A

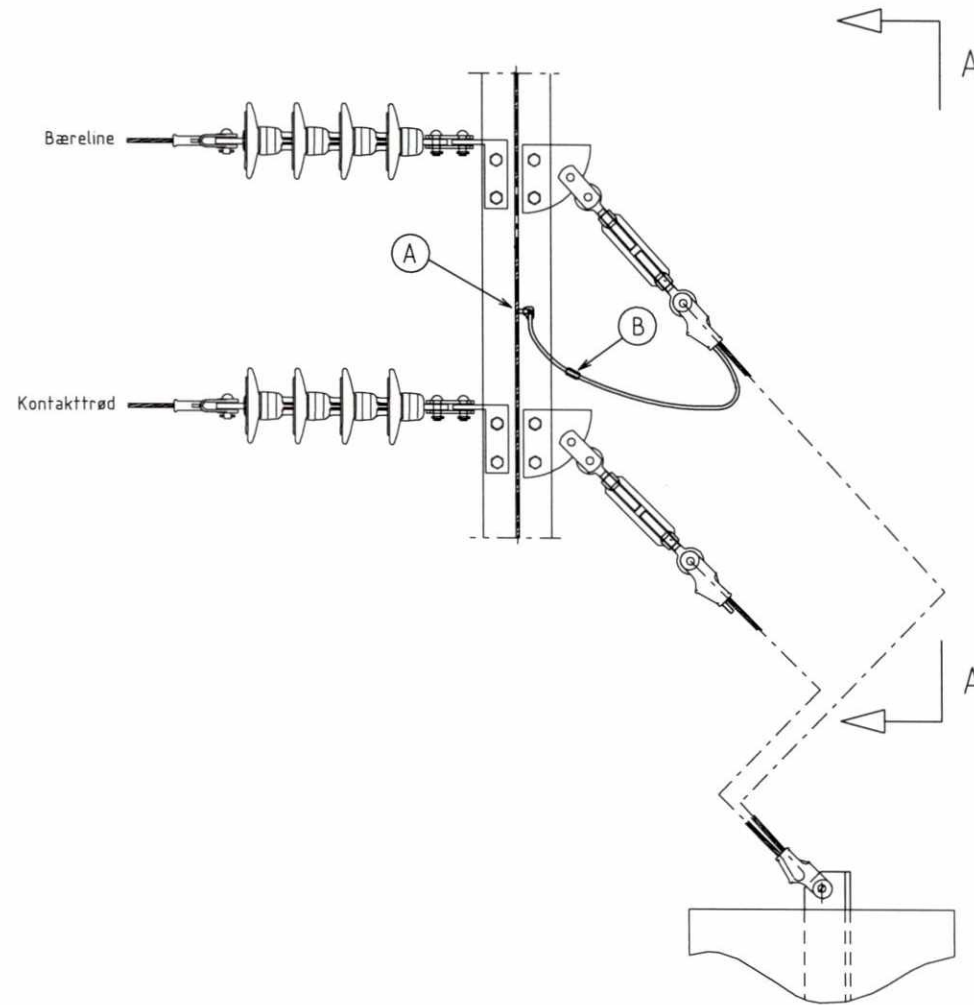

DETALJ A
M 1:2

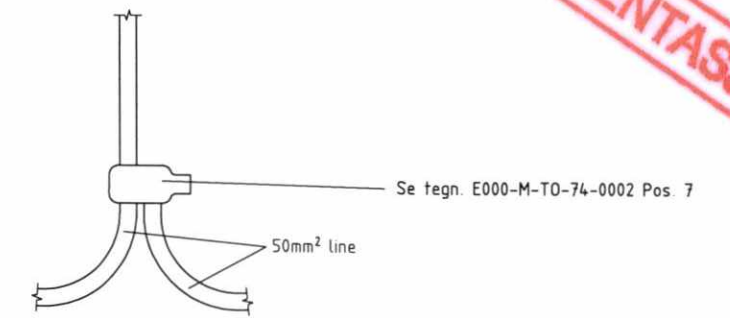

DETALJ B
M 1:2

SLUTTDOKUMENTASJON

F01	31 01 00	Som bygget	FOR	FOR	ALA
Rev	Dato	Endring - erstatning	Tegn	Saksh	Sign
NSB Gardermobanen A/S			Dato		
ABB Energi AS - kontrakt K-1839			DA	28 05 97	
Kontrakt nr	Leverandør		DA	Dato	
	ABB ABB Kraft AS		DAK nr		
Anvendelse	Leverandør tegn nr		Hor M	Vert M	
	9BET010042-JPR		Ark bet	1:10	
Parcell			Erstatn for		
Overblik			Overblikkode		
Tilset - beskrivelse	JORDING AV BARDUN			000	
GMD tegn nr	E000-M-T0-74-0028		Rev	F01	
NSB tegn nr			Rev		